


0 5' 10'
SCALE

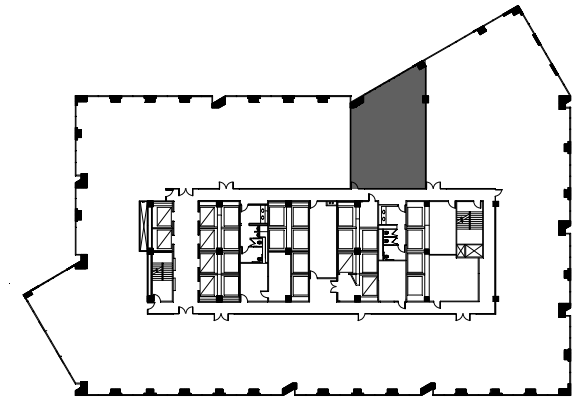

10TH FLOOR



For Leasing information:
214-855-3710

AS-BUILT PLAN

DATE: 10-29-08

DRAWN BY: MFJ

1700
PACIFIC

SUITE 1015

RSF: 1,836

PROJECT NO: 0383-1336-16

INTERPRISE