


11'7"X22'10"



SCALE

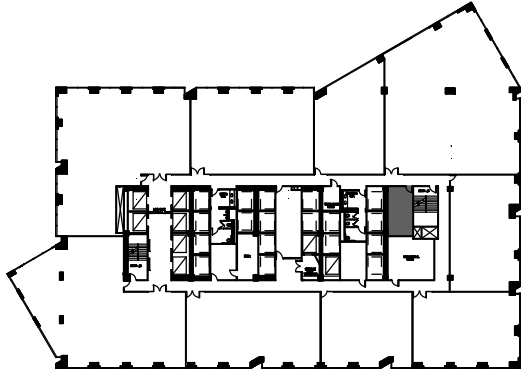

10TH FLOOR 

For Leasing information:
214-855-3710

AS-BUILT PLAN

DATE: 07-13-09

DRAWN BY: RLW/TH

**1700
PACIFIC**

**SUITE 1025
INTERIOR SPACE**

RSF: 318

PROJECT NO: 0383-1336-16

INTERPRISE