


0 5' 10'

SCALE

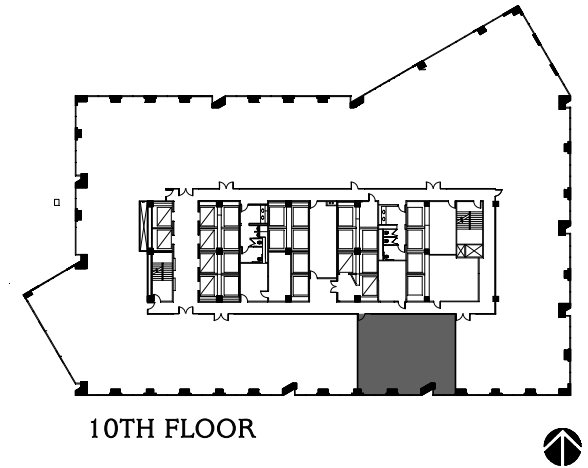

For Leasing information:  
214-855-3710

AS-BUILT PLAN

DATE: 10-29-08 DRAWN BY: MFJ

1700  
PACIFIC

SUITE 1040

RSF: 1,790 PROJECT NO: 0383-1336-16

INTERPRISE