
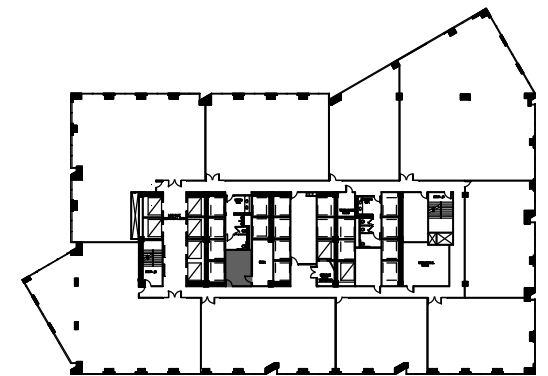


0 5' 10'
SCALE

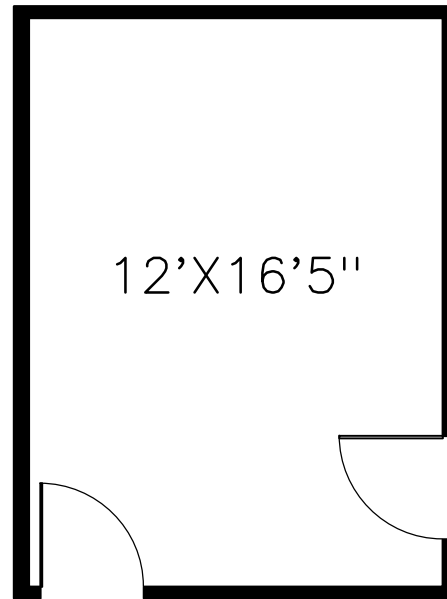

10TH FLOOR 

For Leasing information:
214-855-3710

AS-BUILT PLAN

DATE: 10-29-08 DRAWN BY: MFJ

1700
PACIFIC

SUITE 1055
INTERIOR SPACE

RSF: 224 PROJECT NO: 0383-1336-16

INTERPRISE