
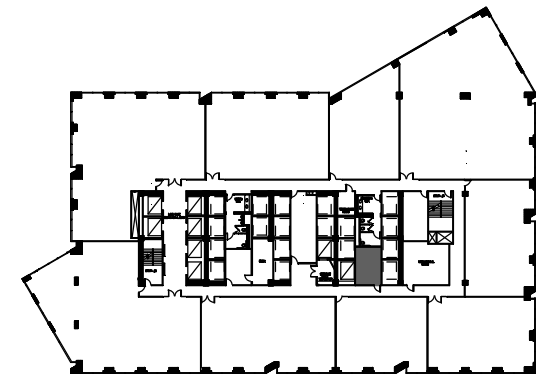


0 5' 10'
SCALE

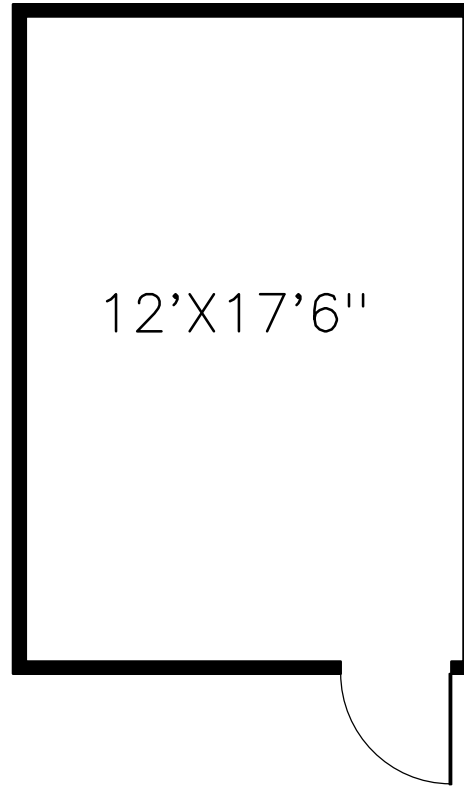

10TH FLOOR 

For Leasing information:
214-855-3710

AS-BUILT PLAN

DATE: 07-13-09 DRAWN BY: RLW/TH

**1700
PACIFIC**

**SUITE 1065
INTERIOR SPACE**

RSF: 251 PROJECT NO: 0383-1336-16

INTERPRISE