




0 5' 10' 20'
SCALE

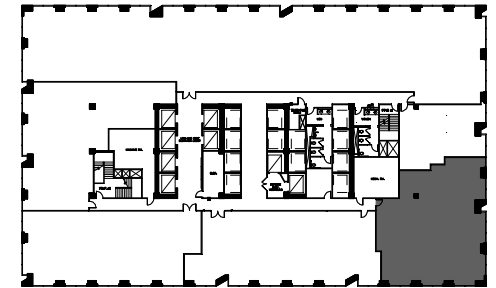

16TH FLOOR



For Leasing information:
214-855-3710

AS-BUILT PLAN

DATE: 10-29-08

DRAWN BY: SR

1700
PACIFIC

SUITE 1630

RSF: 3,026

PROJECT NO: 0383-1336-16

INTERPRISE