


0 5' 10'
SCALE

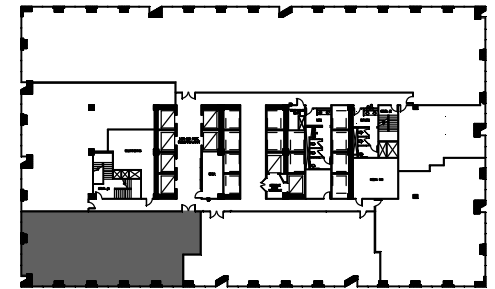

16TH FLOOR



For Leasing information:
214-855-3710

AS-BUILT PLAN

DATE: 07-14-09

DRAWN BY: RLW/TH

1700
PACIFIC

SUITE 1650

RSF: 3,288

PROJECT NO: 0383-1336-16

INTERPRISE