


SCALE

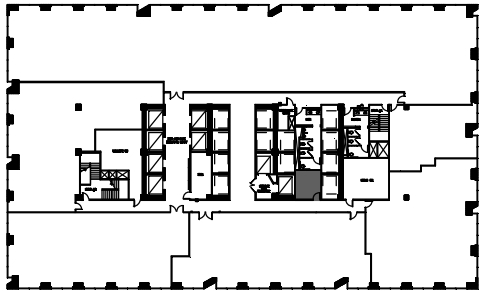

16TH FLOOR 

For Leasing information:
214-855-3710

AS-BUILT PLAN

DATE: 07-13-09 DRAWN BY: RLW/TH

**1700
PACIFIC**

**SUITE 1655
INTERIOR SPACE**

RSF: 356 PROJECT NO: 0383-1336-16

INTERPRISE