


0 5' 10'  
SCALE



18TH FLOOR

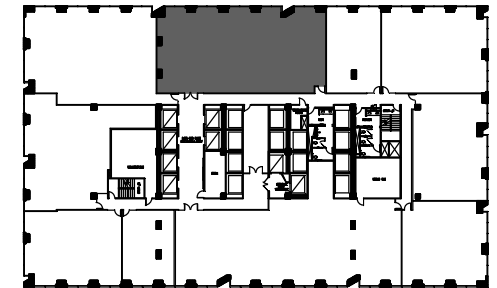

For Leasing information:  
214-855-3710

**AS-BUILT PLAN**

DATE: 06-18-07 DRAWN BY: MAC

**1700**  
PACIFIC

**SUITE 1800**

RSF: 3,610 PROJECT NO: 0383-1373-16

**INTERPRISE**