


0 5' 10'
SCALE



18TH FLOOR

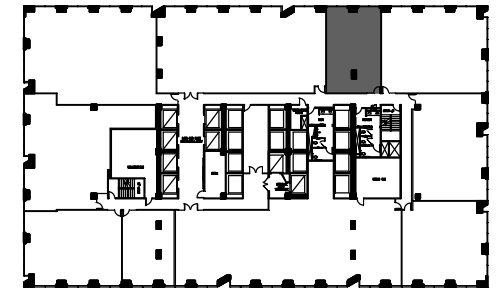

For Leasing information:
214-855-3710

AS-BUILT PLAN

DATE: 06-18-07 DRAWN BY: MAC

1700
PACIFIC

SUITE 1810

RSF: 1,186 PROJECT NO: 0383-1373-16

INTERPRISE