


0 5' 10'  
SCALE

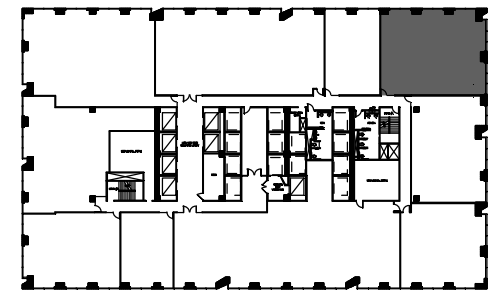

22ND FLOOR 

For Leasing information:  
214-855-3710

**AS-BUILT PLAN**

DATE: 09-16-09 DRAWN BY: RLW

**1700  
PACIFIC**

**SUITE 2220**

RSF: 2,276 PROJECT NO: 0383-1336-16

**INTERPRISE**