




11'8"X31'6"



**SCALE**

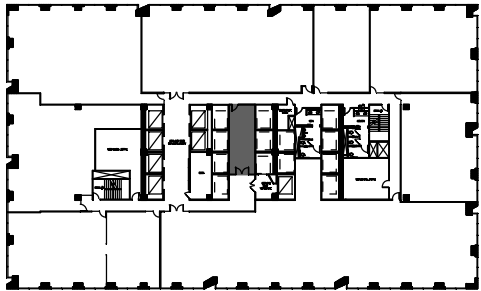

22ND FLOOR 

For Leasing information:  
214-855-3710

**AS-BUILT PLAN**

DATE: 07-14-09 DRAWN BY: RLW/TH

**1700  
PACIFIC**

**SUITE 2295  
INTERIOR SPACE**

RSF: 538 PROJECT NO: 0383-1336-16

**INTERPRISE**