


0 5' 10'
SCALE

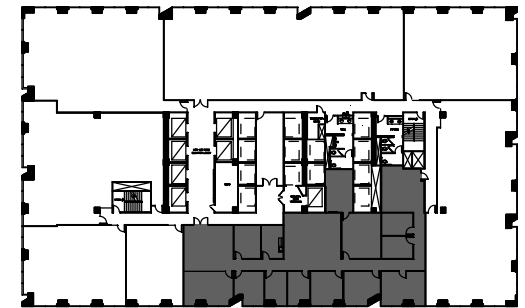

23RD FLOOR 

For Leasing information:
214-855-3710

AS-BUILT PLAN

DATE: 06-24-09 DRAWN BY: RLW

**1700
PACIFIC**

SUITE 2350

RSF: 5,555 PROJECT NO: 0383-1336-16

INTERPRISE