


0 5' 10'  
SCALE

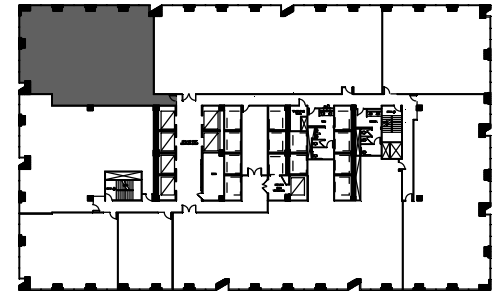

23RD FLOOR 

For Leasing information:  
214-855-3710

AS-BUILT PLAN

DATE: 07-14-09

DRAWN BY: RLW/TH

**1700**  
PACIFIC

SUITE 2390

RSF: 3,241

PROJECT NO: 0383-1336-16

**INTERPRISE**