
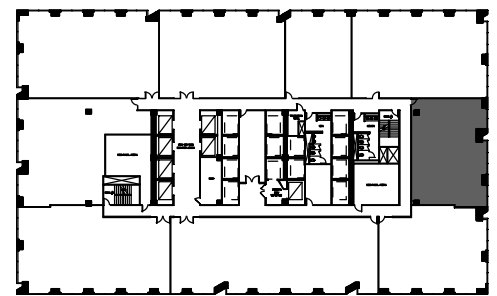


0 5' 10'
SCALE

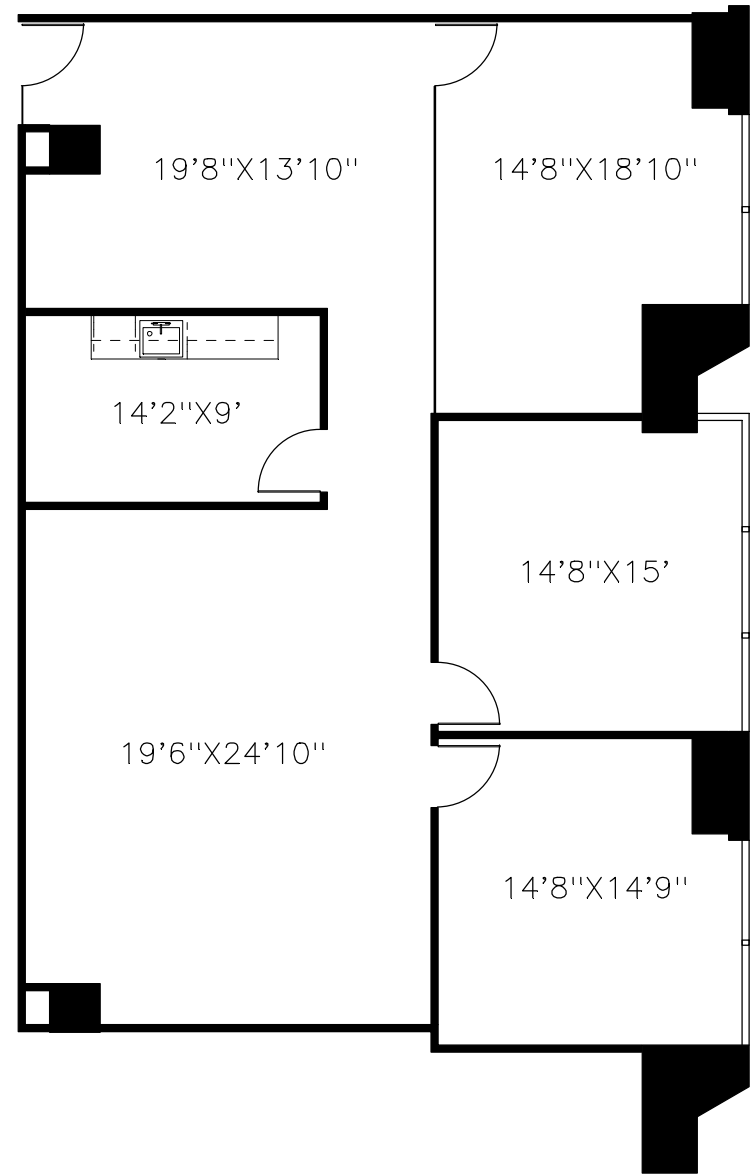

For Leasing information:
214-855-3710

AS-BUILT PLAN

DATE: 10-23-09 DRAWN BY: RLW

1700
PACIFIC

SUITE 2630

RSF: 2,050 PROJECT NO: 0383-1336-16

INTERPRISE