


0 5' 10' 20'
SCALE

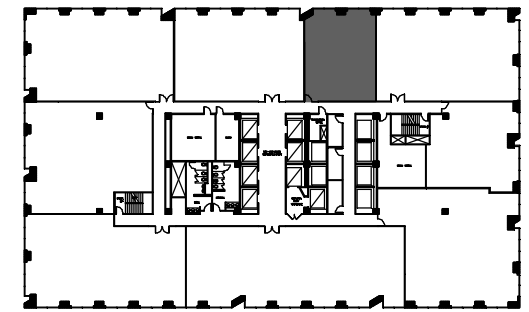

36TH FLOOR 

For Leasing information:
214-855-3710

AS-BUILT PLAN

DATE: 05-22-09 DRAWN BY: RLW

**1700
PACIFIC**

SUITE 3610

RSF: 1,498 PROJECT NO: 0385-1398-16

INTERPRISE