
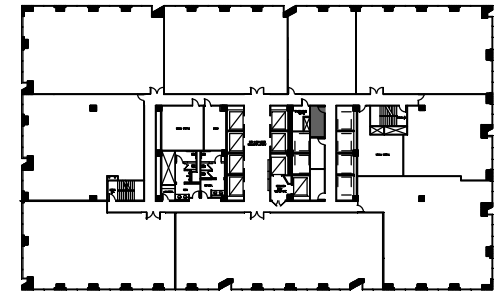


0 5' 10'

**SCALE**

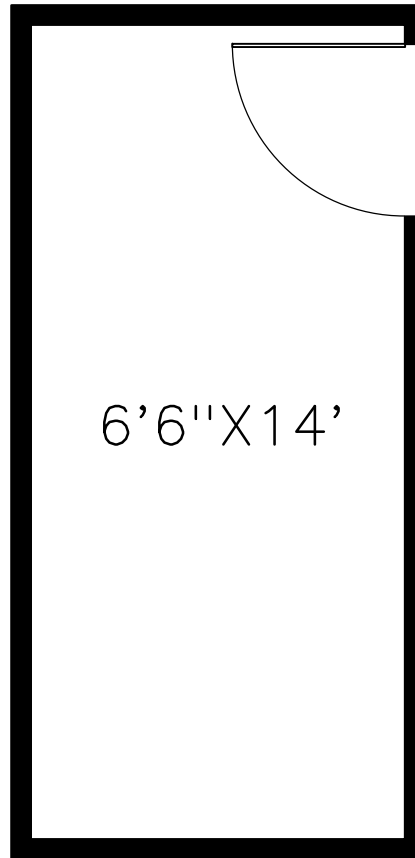

36TH FLOOR 

For Leasing information:  
214-855-3710

**AS-BUILT PLAN**

DATE: 07-14-09

DRAWN BY: RLW/TH

**1700  
PACIFIC**

**SUITE 3691  
INTERIOR SPACE**

RSF: 110

PROJECT NO: 0383-1336-16

**INTERPRISE**