
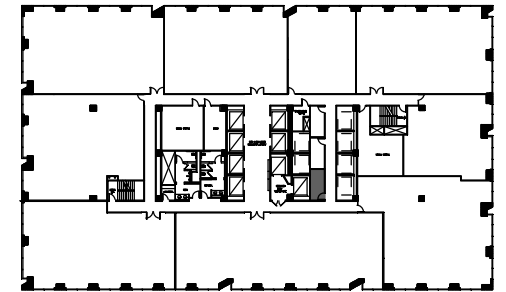


0 5' 10'

SCALE

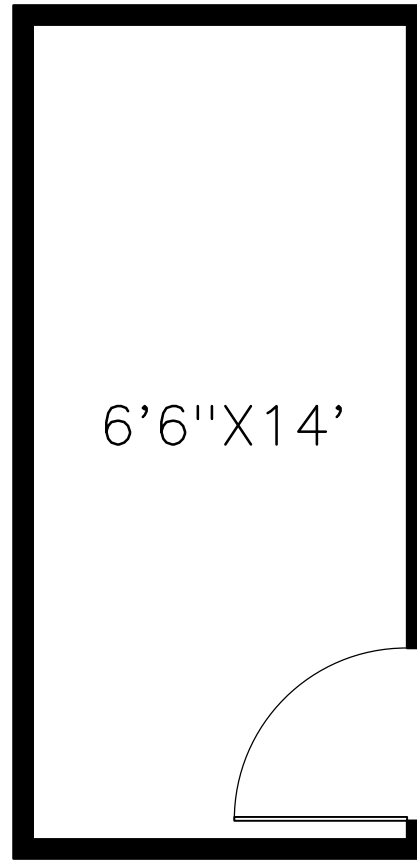

36TH FLOOR 

For Leasing information:
214-855-3710

AS-BUILT PLAN

DATE: 07-14-09

DRAWN BY: RLW/TH

**1700
PACIFIC**

**SUITE 3693
INTERIOR SPACE**

RSF: 110

PROJECT NO: 0383-1336-16

INTERPRISE