


0 5' 10'
SCALE

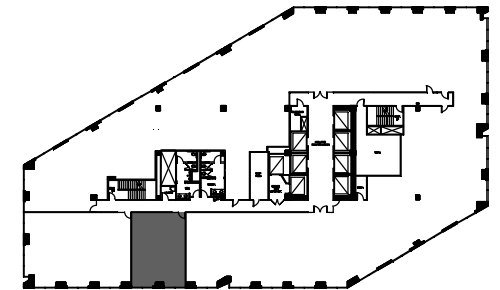

46TH FLOOR

For Leasing information:
214-855-3710

AS-BUILT PLAN

DATE: 06-18-07

DRAWN BY: MAC

1700
PACIFIC

SUITE 4670

RSF: 1,024

PROJECT NO: 0383-1373-16

INTERPRISE