


0 5' 10'  
SCALE

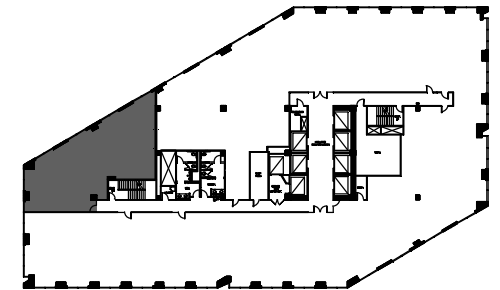

46TH FLOOR

For Leasing information:  
214-855-3710

**AS-BUILT PLAN**

DATE: 06-18-07 DRAWN BY: MAC

**1700**  
PACIFIC

**SUITE 4690**

RSF: 2,485 PROJECT NO: 0383-1373-16

**INTERPRISE**