


0 5' 10'  
SCALE

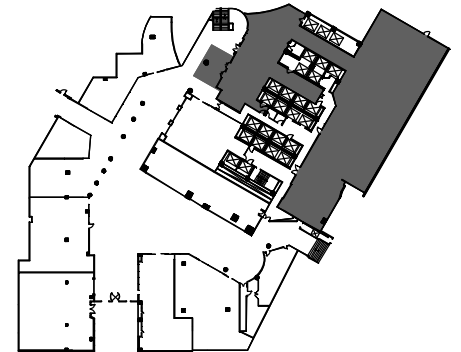

CONCOURSE 

For Leasing information:  
214-855-3710

**AS-BUILT PLAN**

DATE: 06-14-07

DRAWN BY: AP/TH

**1700**  
**PACIFIC**

**SUITE C100**

RSF: 12,478

PROJECT NO: 0383-1373-16

**INTERPRISE**