


0 5' 10'

SCALE

ALL ROOM SIZES ARE APPROXIMATE

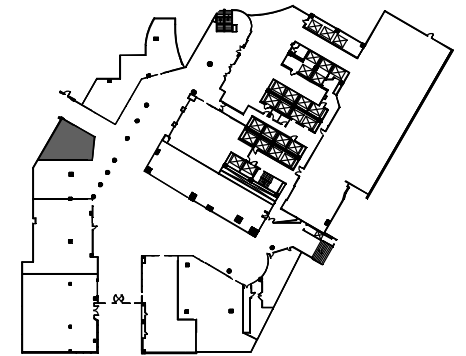

CONCOURSE



For Leasing information:
214-855-3710

AS-BUILT PLAN

DATE: 06-02-09

DRAWN BY:

RLW

1700
PACIFIC

SUITE C105

RSF:

925

PROJECT NO: 0383-1336-16

INTERPRISE