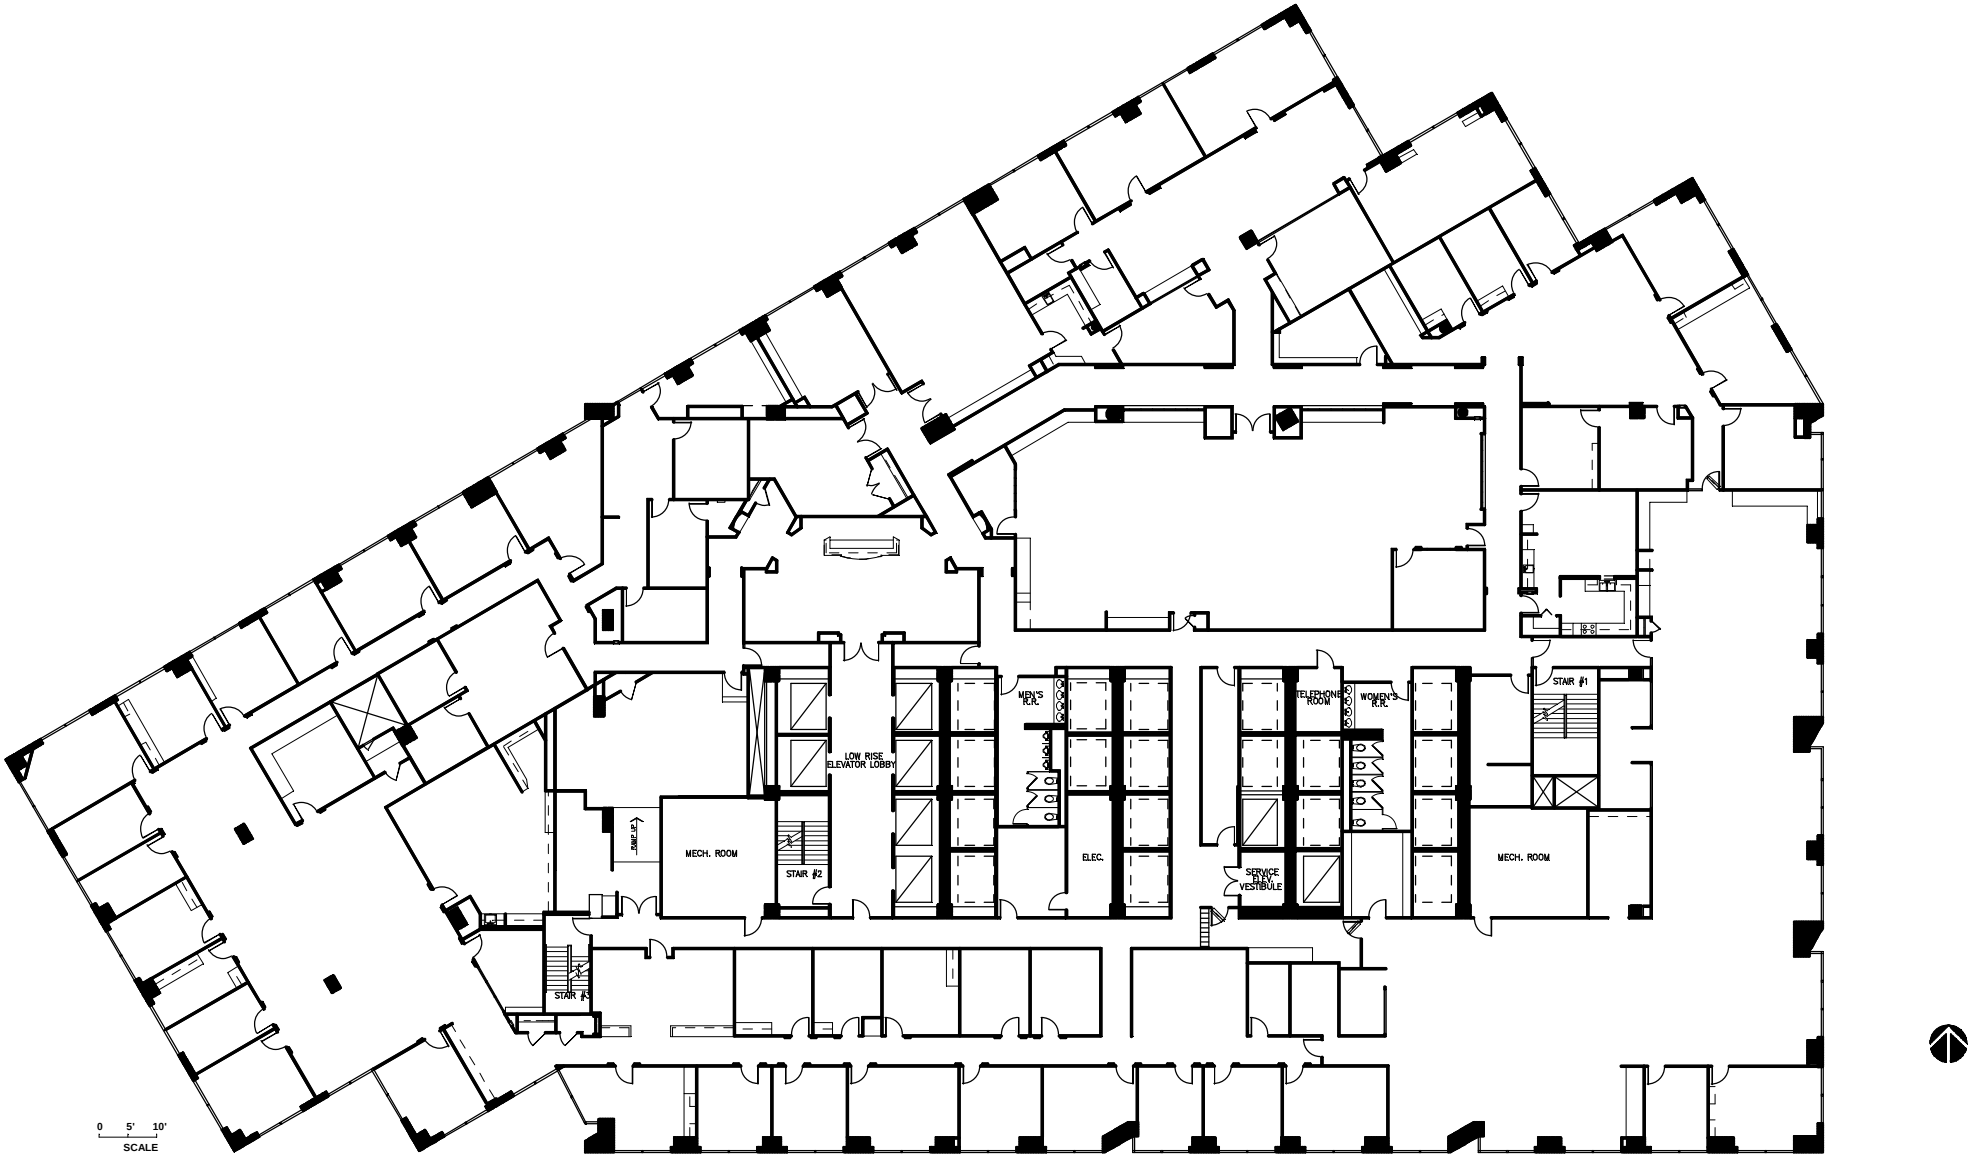

For Leasing information:
214-855-3710

AS-BUILT PLAN

DATE: 06-14-07 | DRAWN BY: TPH/TH

1700 PACIFIC

SUITE 500

RSF: 42,021 | PROJECT NO: 0383-1373-16

INTERPRISE